



उ० प्र० रारकार का उपक्रम

# Dakshinanchal Vidyut Vitran Nigam Ltd.,

Urja Bhawan, 220KV S/s Bye-Pass Road, Sikandra, Agra

Telefax. # 0562-2603736, E-mail- serapdrpdvvn1@gmail.com

CIN : U31200UP2003SGC027460

No. 8340 /S.E.-II (MM)/DVVNL-MM/1550-2015

Dated: 22.6.18

Sub.: Approval of GTP/Drawings/Vendor of Material/Equipment.

Ref: -

1. LOI No. 7774/S.E.(MM)/DVVNL-MM/1550-2015 Dated. 24.06.2016 (IPDS)
2. Request letter No.: SRCIL/IPDS/Approval/2018-19/124 Dated:15.06.2018

M/s R. K. Industries Ltd.

35/1/1, Kamla Nehru Marg, Rampur Garden,  
Bareilly U.P. (India)

Mob. No. 7533903707

E-Mail - rkindustriesbly@rediffmail.com

Dear Sir,

With above reference, following GTPs/Drawings/Vendors are, hereby, approved for taking necessary procurement action at your end-

Sl. No.	Item	Name of Vendors
1.	Fencing with gate for DT S/S(4Mx4Mx3m)	M/s. ARC Insulation & Insulators Pvt.Ltd.Bawali, West Bengal

**Remark: Tolerance limits, unless otherwise mentioned specifically in above GTP, Shall be as per Prevailing IS.**

Correction wherever required in G.T.P. & Drawing submitted by the contractor has been done by red ink. However, these G.T.P. & Drawing shall be subject to correctness as per technical specification of the tender document and the entire responsibility of the correctness of the G.T.P. & Drawing as per the specification as well as supply of material according to the technical specification of the contract agreement and these G.T.P. & Drawing shall be that of the contractor.

In case of any contradiction between G.T.P. & Drawing & Technical Specification the version of the M.D. DVVNL, Agra shall be final and binding on both the parties. Contractor shall have to replace the material to the entire satisfaction of purchaser in case the material is not found suitable for use in the projects.

One copy of approved drawings are enclosed herewith.

Encl.: As above

Your's faithfully,

(A.K. Rawal)

Superintending Engineer-II (MM)

Dated: 22.6.18

No. 8340 /S.E.-II (MM)/DVVNL-MM/1550-2015

Copy forwarded to the following for information and necessary action:-

1. Superintending Engineer (C.E.O.), Electricity Distribution Circle Etah.
2. M/s Electrical Research and Development Association (ERDA), Site Office, DVVNL, Agra.

(A.K. Rawal)

Superintending Engineer-II (MM)

**ARC**

Insulations &amp; Insulators (P) Ltd.

GSTIN - 19AAHCA6355Q1ZX

CIN No.: U18109WB2008PTC129263

M a n u f a c t u r e r o f F i b e r g l a s s C o m p o s i t e s

FOR ETAH & KASGANJ IPDS	
PROJECT:-	Urban Electrification Works in the selected towns in district(s) ETAH & KASGANJ (Kanshiram Nagar) in DVVNL under IPDS Scheme.
CUSTOMER:-	DVVNL, Agra
CONTRACTOR:-	M/s R K INDUSTRIES (A Unit of S R Chaddha Industries Ltd), Bareilly
LOI NO.:-	7774/S.E (MM)/DVVNL-MM/1550-2015 (IPDS), Dated-24-06-2016.
MANUFACTURER:-	ARC INSULATION & INSULATORS PVT. LTD.

**GTP FOR FRP FENCING**

Sl. No.	Particulars	Specified	Offer
1	Manufacturer Name	ARC Insulation & Insulators Pvt. Ltd.	
2	Material of Fencing	FRP	Confirmed
3	Heat Deflection as per IS 13411	Min 120 Deg. & Max 180 Deg.	Confirmed
4	Melting point as per IS 13360	Does not melt at 250 Deg. Celcius	Confirmed
5	Dimension of the Fencing	4000 mm x 4000 mm x 3000 mm (L x W x H)	Confirmed
6	Dimensional Tolerance	± 5 %	Confirmed
7	Width x Height for Three Sides	2000 mm x 3000 mm per unit (2 nos. each side)	Confirmed
8	Front View of Fencing (As per Drawing)	1500 mm x 3000 mm	Confirmed
9	Gate of Entry (As per Drawing)	3000 mm x 500 mm (2 nos.)	Confirmed
10	Material of Vertical Box Section	FRP	Confirmed
11	Size of Box	50 x 50 x 3 mm	Confirmed
12	Material of Rod	FRP	Confirmed
13	Size of Rod	12 mm Dia	Confirmed
14	Material I section	FRP	Confirmed
15	Size of I Section	38 x 15 x 3 mm	Confirmed
16	Material of C Channel	FRP	Confirmed
17	Size of C Channel	60 X 24 X 4 mm	Confirmed
18	I Section placed Horizontally	At 150 mm C/C Distance	Confirmed
19	Rod Section placed Vertically	At 195 mm C/C Distance	Confirmed
20	Hinges	4 Nos.	Confirmed
21	Material of Hinges	Aluminium	Confirmed
22	Gate Locking	1 No.	Confirmed
23	Material of Locking	Aluminium Aldrop	Confirmed
24	Joint/Fixing Type	Aluminium Rivet	Confirmed
25	Suitable for Outdoor Installation	Yes	Confirmed
26	Color	Yellow	Confirmed

For ARC Insulations &amp; Insulators Pvt. Ltd.

ARC INSULATION &amp; INSULATORS PVT. LTD.

Notwithstanding the aforesaid approval the entire responsibility of the correctness and supply of material according to the specification shall be that of the contractor

**APPROVED**

Manish Bajoria  
(Director)

E.E.

S.E.

Correspondence:


South City Apartments, 4th Floor, 200, 5th P.A. Street Road, Kolkata - 700060, Behind South City Mall. M : 9748708809 | 9831031917

Works &amp; Regd. Office:

Village Ramdevpur, P.O. Bawali, P.S. Bishnupur, 24 Pgs. (S), Pin - 743384, West Bengal. Tel: +91 33 2495 4231, Fax: 2495 4233


Mobile : 9831031917, 9748708809, Email: manishbajoria203@hotmail.com, www.arcinsulations.com



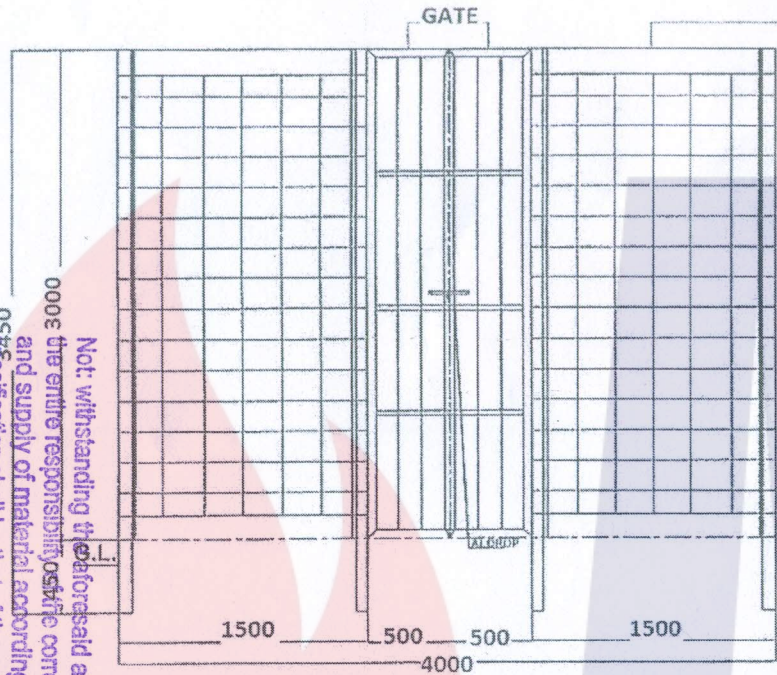

ELEVATION

CHANNEL SECTION

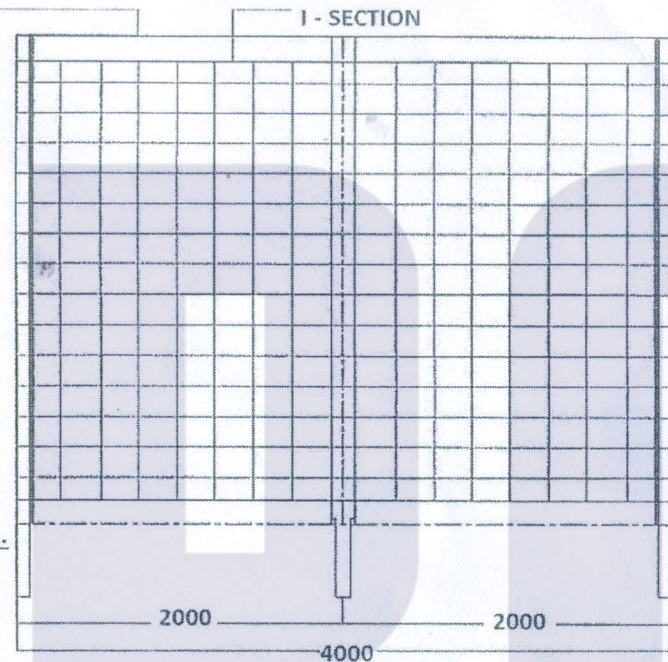

SIDE VIEW

E.E. Material Management Unit, DVVNL, AGRA

*[Handwritten signature]*

APPROVED

*[Handwritten signature]*

Notwithstanding the aforesaid approval of the contractor, the entire responsibility for the correctness and supply of material according to the specification shall be that of the contractor.

FOR ETAH & KASGANJ IPDS	
PROJECT:-	Urban Electrification Works in the selected towns in district(s) ETAH & KASGANJ (Kanshiram Nagar) in DVVNL under IPDS Scheme.
CUSTOMER:-	DVVNL, Agra
CONTRACTOR:-	M/s R K INDUSTRIES (A Unit of S R Chaddha Industries Ltd), Bareilly
LOI NO.:-	7774/S.E (MM)/DVVNL-MM/1550-2015 (IPDS), Dated-24-06-2016.
MANUFACTURER:-	ARC INSULATION & INSULATORS PVT. LTD.

\* marking for danger symbol and name of DVVNL/IPDS shall be done on a plate and fix it on the front side of the fencing



	<b>ARC INSULATION &amp; INSULATORS PVT. LTD.</b>		
	VILL - RAMDEVPUR, P.O - BAWALI, DISTRICT - 24 PARGANA (S), PIN - 743384		
	DATE: 09.06.2018	REV: 0	DRG. NO.: ARC/18-19/FENCING/0026
	SHEET : 1 OF 1		
	DRAWN BY: SUBHADIP	CHECKED BY: ANUP	APPROVED BY: MANISH
TITLE - FRP FENCING			